

Date: Thursday, 3/2/2006 3:08:31 PM
User: Kim Johnston

Process Sheet

Customer	: CU-DAR001 Dart Helicopters Services	Drawing Name	: BRACKET ASSEMBLY
Job Number	: 26043		
Estimate Number	: 10290		
P.O. Number	: N/A	Part Number	: D3121144
This Issue	: 3/2/2006	S.O. No.	: N/A
Prsht Rev.	: NC	Drawing Number	: D3121 REV C2
First Issue	: N/A	Project Number	: N/A
Previous Run	: 25557B	Drawing Revision	: C2
		Material	: N/A
Written By	: <u>SEE COMMENT BELOW</u>	Due Date	: 3/30/2006
Checked & Approved By	: <u>JL 06.03.02</u>	Qty:	2 Um: Each
Comment	: Est Rev: Pick: A 04.02.18 New issue KJ/DS		

Additional Product

Job Number:



Seq. #:	Machine Or Operation:	Description :
---------	-----------------------	---------------

1.0	M174B1000X02000	17-4 SS Bar
-----	-----------------	-------------



Comment: Qty.: 0.3864 f(s)/Unit Total: 0.7728 f(s)
Material: 17-4 SS Bar per AMS 5604/5643
(M17-4-B1.000x02.000)
Identify for D3121-114
Batch: M19712

J.L 06.03.14

2

2.0	BAND SAW	BAND SAW
-----	----------	----------



Comment: BAND SAW
Cut blanks: (1.000" x 2.000") 4.425" long

J.L 06.03.14

2

3.0	HAAS1	HAAS CNC VERTICAL MACHINING #1
-----	-------	--------------------------------



Comment: HAAS CNC VERTICAL MACHINING #1

1-Machine D3121-114 as per Folio FA330 and Dwg D3121 Identify as D3121-114

2-Deburr

3-Scribe batch number

J.L 06.03.15

2

4.0	QC2	INSPECT PARTS AS THEY COME OFF MACHINE
-----	-----	--



Comment: INSPECT PARTS AS THEY COME OFF MACHINE

J.L 06.03.14

2

Dart Aerospace Ltd

W/O:		WORK ORDER CHANGES					
DATE	STEP	PROCEDURE CHANGE	By	Date	Qty	Approval Chief Eng / Prod Mgr	Approval QC Inspector

Part No: D3121-144 PAR #: N/A Fault Category: Red/Machined Parts NCR: Yes No DQA: Date: 06/03/15
 QA: N/C Closed: Date: 06.03.16

NCR: <u>26043</u>		WORK ORDER NON-CONFORMANCE (NCR)						
DATE	STEP	Description of NC Section A	Corrective Action Section B			Verification Section C	Approval Chief Eng	Approval QC Inspector
			Initial Chief Eng	Action Description Chief Eng	Sign & Date			
06-06-14	3	All four slots are shifted down on one part. 0.160" dim is 0.142". See attached email	<u>UP</u> 06.03.15 per Q51042	Part is OK per email (attached)	<u>J.L</u> 06.03.15	<u>AB</u> 06.03.15	<u>UP</u> 06.03.15 per Q51042	<u>AB</u> 06.03.15

NOTE: Date & initial all entries

Date: Thursday, 3/2/2006 3:08:31 PM
User: Kim Johnston

Process Sheet

Customer: CU-DAR001 Dart Helicopters Services

Drawing Name: BRACKET ASSEMBLY

Job Number: 26043

Part Number: D3121144

Job Number:



Seq. #:

Machine Or Operation:

Description :

5.0

QC8

SECOND CHECK



Comment: SECOND CHECK

En 06/03/15 2

6.0

D312121

Bolt



Comment: Qty.: 2.0000 Each(s)/Unit Total: 4.0000 Each(s)

Pick:

Qty Part Number

Description Batch

2 D3121-21

Bolt

B25560

J.L 06.03.15 2

7.0

D3121241

Bearing Assembly



Comment: Qty.: 2.0000 Each(s)/Unit Total: 4.0000 Each(s)

Pick:

Qty Part Number

Description Batch

2 D3121-241 Bearing Ass

B25477

J.L 06.03.15 2

8.0

SMALL FAB 1

SMALL & MEDIUM FAB RESOURCE 1



Comment: SMALL & MEDIUM FAB RESOURCE 1

Assemble D3121-143 as per Dwg D3121.

J.L 06.03.15 2

9.0

QC5

INSPECT WORK TO CURRENT STEP



Comment: INSPECT WORK TO CURRENT STEP

En 06/03/15 2

10.0

PACKAGING 1

PACKAGING RESOURCE #1



Comment: PACKAGING RESOURCE #1

Identify and Stock

Location:

SI408

C 206/03/15 (2)

11.0

DC

DOCUMENT CONTROL



Comment: DOCUMENT CONTROL

Inspection Level 21

SP 06/03/16 (2)

Job Completion



h 06/03/15

W/O:		WORK ORDER CHANGES					
DATE	STEP	PROCEDURE CHANGE	By	Date	Qty	Approval Chief Eng / Prod Mgr	Approval QC Inspector

Part No: _____ PAR #: _____ Fault Category: _____ NCR: Yes No DQA: _____ Date: _____

QA: N/C Closed: _____ Date: _____

NCR:		WORK ORDER NON-CONFORMANCE (NCR)						
DATE	STEP	Description of NC Section A	Corrective Action Section B			Verification Section C	Approval Chief Eng	Approval QC Inspector
			Initial Chief Eng	Action Description Chief Eng	Sign & Date			

NOTE: Date & initial all entries

DART AEROSPACE LTD		Work Order:	
Description: Bracket		Part Number:	D3121-114
Inspection Dwg: D3121	Rev: C2	Page 1 of 2	

FIRST ARTICLE INSPECTION CHECKLIST

☒ First Article ☐ Prototype

Drawing Dimension	Tolerance	Actual Dimension	Accept	Reject	Method of Inspection	Comments
0.080	+/-0.010	.081	✓			
0.300	+/-0.010	.300	✓			
R0.375	+/-0.010	.375	✓			
1.54	+/-0.030	1.541	✓			
0.350	+/-0.010	.351				
R0.250	+/-0.010	.250	✓			
1.800	+/-0.030	1.803	✓			
Ø0.392	+0.002/-0.000	.392	✓			
Ø0.201	+0.005/-0.000	.202	✓			
0.100	+/-0.010	.099	✓			
2.540	+/-0.010	2.538	✓			
1.590	+/-0.010	1.588	✓			
0.160	+/-0.010	.158	✓			
0.400	+/-0.010	.409	✓			
1.220	+/-0.010	1.229	✓			
1.600	+/-0.010	1.603	✓			
3.80	+/-0.030	3.810	✓			
1.800	+/-0.010	1.803	✓			
R0.500	+/-0.010	.500	✓			
0.130	+/-0.010	.134	✓			
3.41	+/-0.030	3.410	✓			
3.65	+/-0.030	3.648	✓			
2.24	+/-0.030	2.230	✓			
45°	+/-0.1°	45°	✓			
R0.250	+/-0.010	.250	✓			
3.97	+/-0.030	3.972	✓			
R0.38	+/-0.030	.38	✓			
Ø0.392	+0.002/-0.000	.392	✓			
Ø0.201	+0.005/-0.000	.202	✓			
0.100	+/-0.010	.100	✓			
0.268	+/-0.010	.267	✓			
R0.260	+/-0.010	.260	✓			
0.080	+/-0.010	.081	✓			
0.300	+/-0.010	.302	✓			


RELEASED

10/05/06



DESIGN	DRAWN BY	DART AEROSPACE LTD	
		HAWKESBURY, ONTARIO, CANADA	
CHECKED	APPROVED	DRAWING NO.	REV. C
		D3121	SHEET 1 OF 10
DATE		TITLE	SCALE
04.02.17		BRACKET ASSEMBLY	1:2
A	02.04.15	NEW ISSUE	
B	03.01.16	ADD RIDGES; ADD MAT'L PROP; FIX P/N ADD -141/-143/-144/-145/-146	
C	04.02.17	ADD CLEARANCE; USE -241 BEARING	
C1	04.03.26	3.97 WAS 4.00; 6.11 WAS 6.14	
C2	04.04.26	0.230 WAS 0.238	


RELEASED
04.03.01

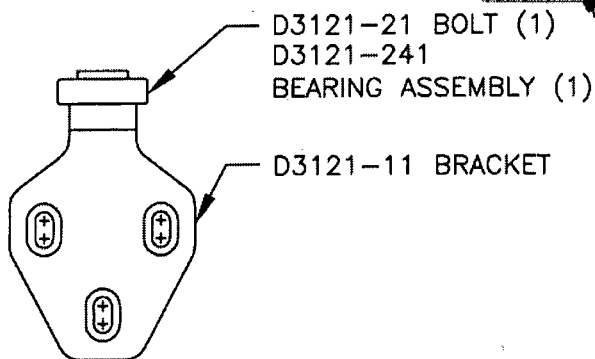

D3121-21 BOLT (1)
D3121-241
BEARING ASSEMBLY (1)

D3121-11 BRACKET


D3121-041 BRACKET ASSEMBLY
(REPLACES PREMIER P/N B30-23000-33)

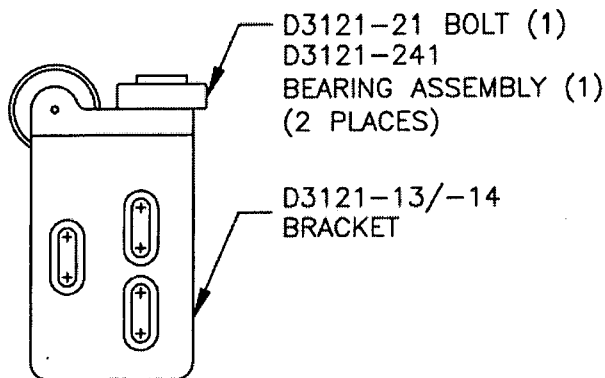

D3121-21 BOLT (1)
D3121-241
BEARING ASSEMBLY (1)
(2 PLACES)

D3121-13/-14
BRACKET

**D3121-043 (SHOWN) / D3121-044 (OPPOSITE)
BRACKET ASSEMBLY**
(REPLACES PREMIER P/N B30-23000-37/-38)

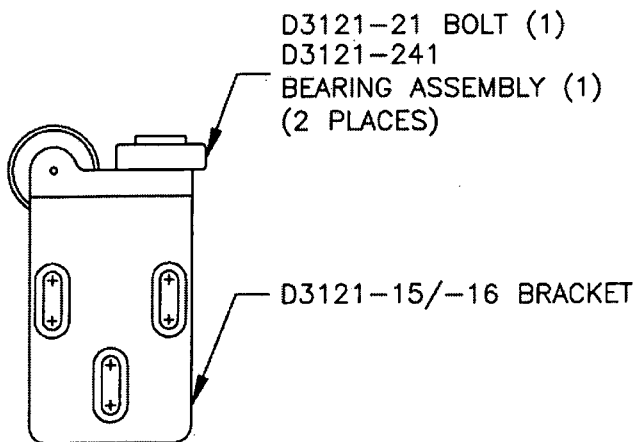

D3121-21 BOLT (1)
D3121-241
BEARING ASSEMBLY (1)
(2 PLACES)

D3121-15/-16 BRACKET

**D3121-045 (SHOWN) / D3121-046 (OPPOSITE)
BRACKET ASSEMBLY**
(REPLACES PREMIER P/N B30-23000-35/-36)


SHOP COPY
RETURN TO
ENGINEERING
UNCONTROLLED COPY
SUBJECT TO AMENDMENT
WITHOUT NOTICE
WORK ORDER
NO. 26043

Copyright © 2002 by DART AEROSPACE LTD

THIS DOCUMENT IS PRIVATE AND CONFIDENTIAL AND IS SUPPLIED ON THE EXPRESS CONDITION THAT IT IS NOT TO BE USED FOR ANY PURPOSE OR COPIED OR COMMUNICATED TO ANY OTHER PERSON WITHOUT WRITTEN PERMISSION FROM DART AEROSPACE LTD.




DESIGN #	DRAWN BY CP	DART AEROSPACE LTD HAWKESBURY, ONTARIO, CANADA	
CHECKED #	APPROVED #	DRAWING NO. D3121	REV. C SHEET 2 OF 10
DATE 04.02.17		TITLE BRACKET ASSEMBLY	SCALE 1:2

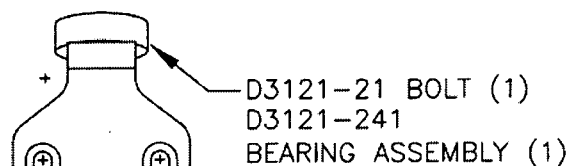

D3121-21 BOLT (1)
D3121-241
BEARING ASSEMBLY (1)

D3121-111 BRACKET

D3121-141 BRACKET ASSEMBLY
(REPLACES PREMIER P/N B30-23001-01)

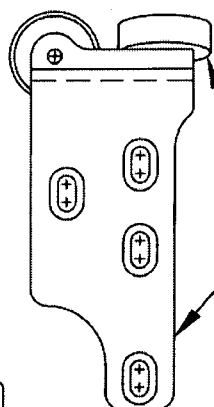


D3121-21 BOLT (1)
D3121-241 BEARING ASSEMBLY (1)
(2 PLACES)

D3121-113/-114 BRACKET

D3121-143 (SHOWN) / D3121-144 (OPPOSITE)
BRACKET ASSEMBLY
(REPLACES PREMIER P/N B30-23000-03/-04)

SHOP COPY
RETURN TO
ENGINEERING
UNCONTROLLED COPY
SUBJECT TO AMENDMENT
WITHOUT NOTICE
WORK ORDER

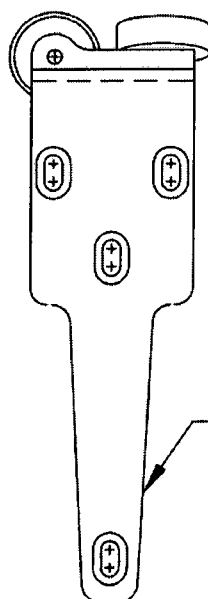

D3121-21 BOLT (1)
D3121-241 BEARING ASSEMBLY (1)
(2 PLACES)

D3121-115/-116
BRACKET

D3121-145 (SHOWN) / D3121-146 (OPPOSITE)
BRACKET ASSEMBLY
(REPLACES PREMIER P/N B30-23000-05/-06)

RELEASED
04.03.01 #

Copyright © 2002 by DART AEROSPACE LTD



THIS DOCUMENT IS PRIVATE AND CONFIDENTIAL AND IS SUPPLIED ON THE EXPRESS CONDITION THAT IT IS NOT TO BE USED FOR ANY PURPOSE OR COPIED OR COMMUNICATED TO ANY OTHER PERSON WITHOUT WRITTEN PERMISSION FROM DART AEROSPACE LTD.



DESIGN #	DRAWN BY CP	DART AEROSPACE LTD HAWKESBURY, ONTARIO, CANADA	
CHECKED #	APPROVED #	DRAWING NO. D3121	REV. C SHEET 3 OF 10
DATE 04.02.17		TITLE BRACKET ASSEMBLY	SCALE 1:1


RELEASED
04.03.01 #

DETAIL A:
SLOT DETAIL
SCALE 2:1
VIEW ROTATED

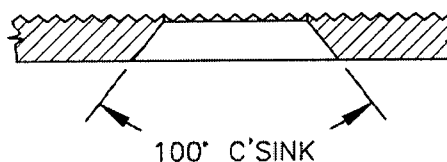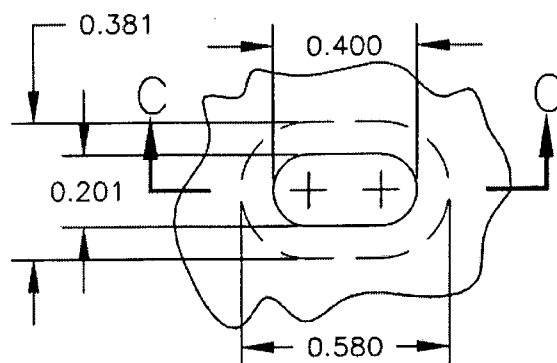

SECTION
C-C

DETAIL B:
RIDGE DETAIL
PARTIAL SECTION
SCALE 1:20

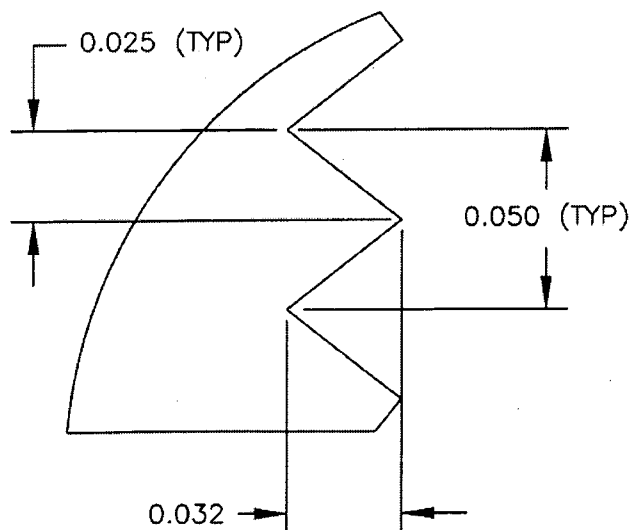


SHOP COPY
RETURN TO
ENGINEERING
UNCONTROLLED COPY
SUBJECT TO AMENDMENT
WITHOUT NOTICE
WORK ORDER
NO. 26043

Copyright © 2002 by DART AEROSPACE LTD

THIS DOCUMENT IS PRIVATE AND CONFIDENTIAL AND IS SUPPLIED ON THE EXPRESS CONDITION THAT IT IS NOT TO BE USED FOR ANY PURPOSE OR COPIED OR COMMUNICATED TO ANY OTHER PERSON WITHOUT WRITTEN PERMISSION FROM DART AEROSPACE LTD.



DESIGN	DRAWN BY	DART AEROSPACE LTD HAWKESBURY, ONTARIO, CANADA	
CHECKED	APPROVED	DRAWING NO. D3121	REV. C SHEET 4 OF 10
DATE 04.02.17	TITLE BRACKET ASSEMBLY		SCALE 1:1

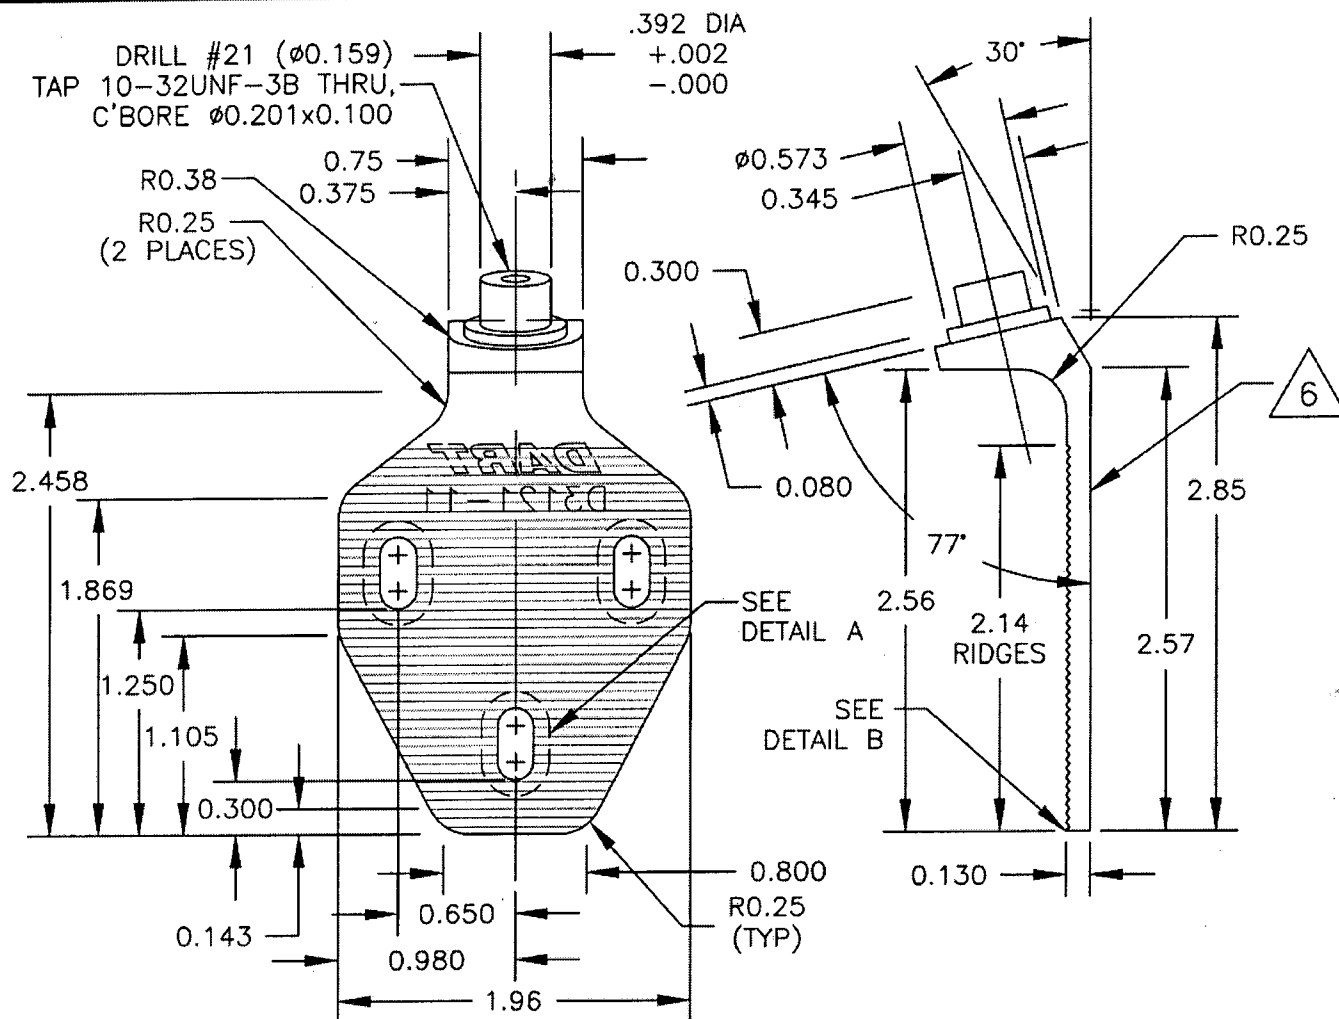

D3121-11 BRACKET

- 1) MATERIAL: 17-4 SS PER AMS 5604/5643 (REF DART SPEC. M17-4-B)
MIN ULTIMATE TENSILE = 150 ksi
MIN YIELD TENSILE = 100 ksi
- 2) TOLERANCES ARE PER DART QSI 018 UNLESS OTHERWISE NOTED
- 3) ALL DIMENSIONS ARE IN INCHES
- 4) BREAK ALL SHARP EDGES 0.005 TO 0.015
- 5) ENGRAVE DART P/N & LOGO AS SHOWN
- 6) HOLE IN SPIGOT TO BE CONCENTRIC WITHIN 0.005





SHOP COPY
RETURN TO
ENGINEERING
UNCONTROLLED COPY
SUBJECT TO AMENDMENT
WITHOUT NOTICE
WORK ORDER
NO. 26043


RELEASED
04.03.01

Copyright © 2004 by DART AEROSPACE LTD

THIS DOCUMENT IS PRIVATE AND CONFIDENTIAL AND IS SUPPLIED ON THE EXPRESS CONDITION THAT IT IS NOT TO BE USED FOR ANY PURPOSE OR COPIED OR COMMUNICATED TO ANY OTHER PERSON WITHOUT WRITTEN PERMISSION FROM DART AEROSPACE LTD.



DESIGN 	DRAWN BY 	DART AEROSPACE LTD HAWKESBURY, ONTARIO, CANADA	
CHECKED 	APPROVED 	DRAWING NO. D3121	REV. C SHEET 5 OF 10
DATE 04.02.18		TITLE BRACKET ASSEMBLY	SCALE 1:2

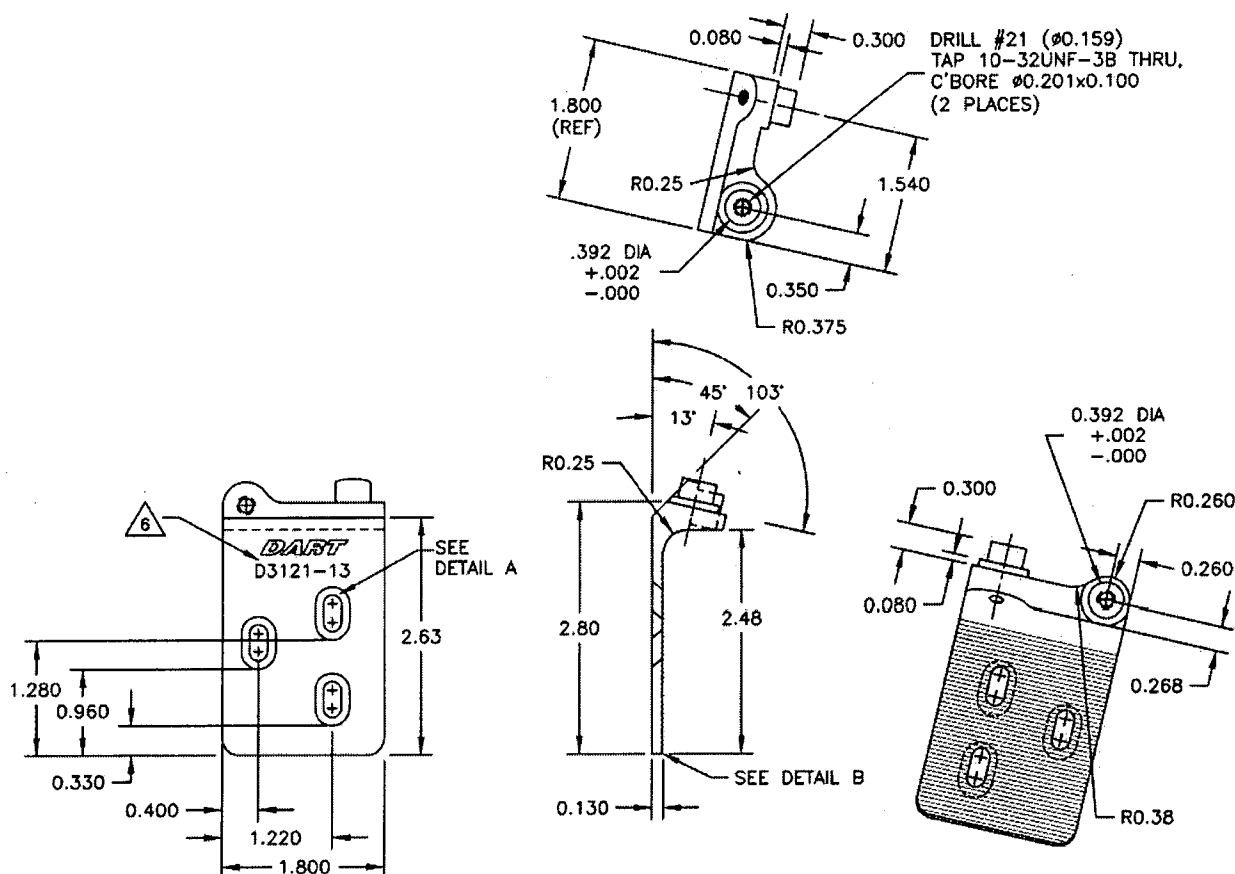

D3121-13 BRACKET (SHOWN)
D3121-14 BRACKET (OPPOSITE)

- 1) MATERIAL: 17-4 SS PER AMS 5604/5643 (REF DART SPEC. M17-4-B)
MIN ULTIMATE TENSILE STRENGTH = 150 ksi
MIN YIELD TENSILE STRENGTH = 100 ksi
- 2) TOLERANCES ARE PER DART QSI 018 UNLESS OTHERWISE NOTED
- 3) ALL DIMENSIONS ARE IN INCHES
- 4) BREAK ALL SHARP EDGES 0.005 TO 0.015
- 5) ENGRAVE DART P/N & LOGO AS SHOWN
- 6) HOLE IN SPIGOT TO BE CONCENTRIC WITHIN 0.005

SHOP COPY
RETURN TO
ENGINEERING
UNCONTROLLED COPY
SUBJECT TO AMENDMENT
WITHOUT NOTICE
WORK ORDER
NO. 26043

RELEASED
04-03-01


Copyright © 2002 by DART AEROSPACE LTD

THIS DOCUMENT IS PRIVATE AND CONFIDENTIAL AND IS SUPPLIED ON THE EXPRESS CONDITION THAT IT IS NOT TO BE USED FOR ANY PURPOSE OR COPIED OR COMMUNICATED TO ANY OTHER PERSON WITHOUT WRITTEN PERMISSION FROM DART AEROSPACE LTD.





DESIGN #	DRAWN BY OP	DART AEROSPACE LTD HAWKESBURY, ONTARIO, CANADA	
CHECKED #	APPROVED #	DRAWING NO. D3121	REV. C SHEET 7 OF 10
DATE 04.02.18		TITLE BRACKET ASSEMBLY	SCALE 1:2

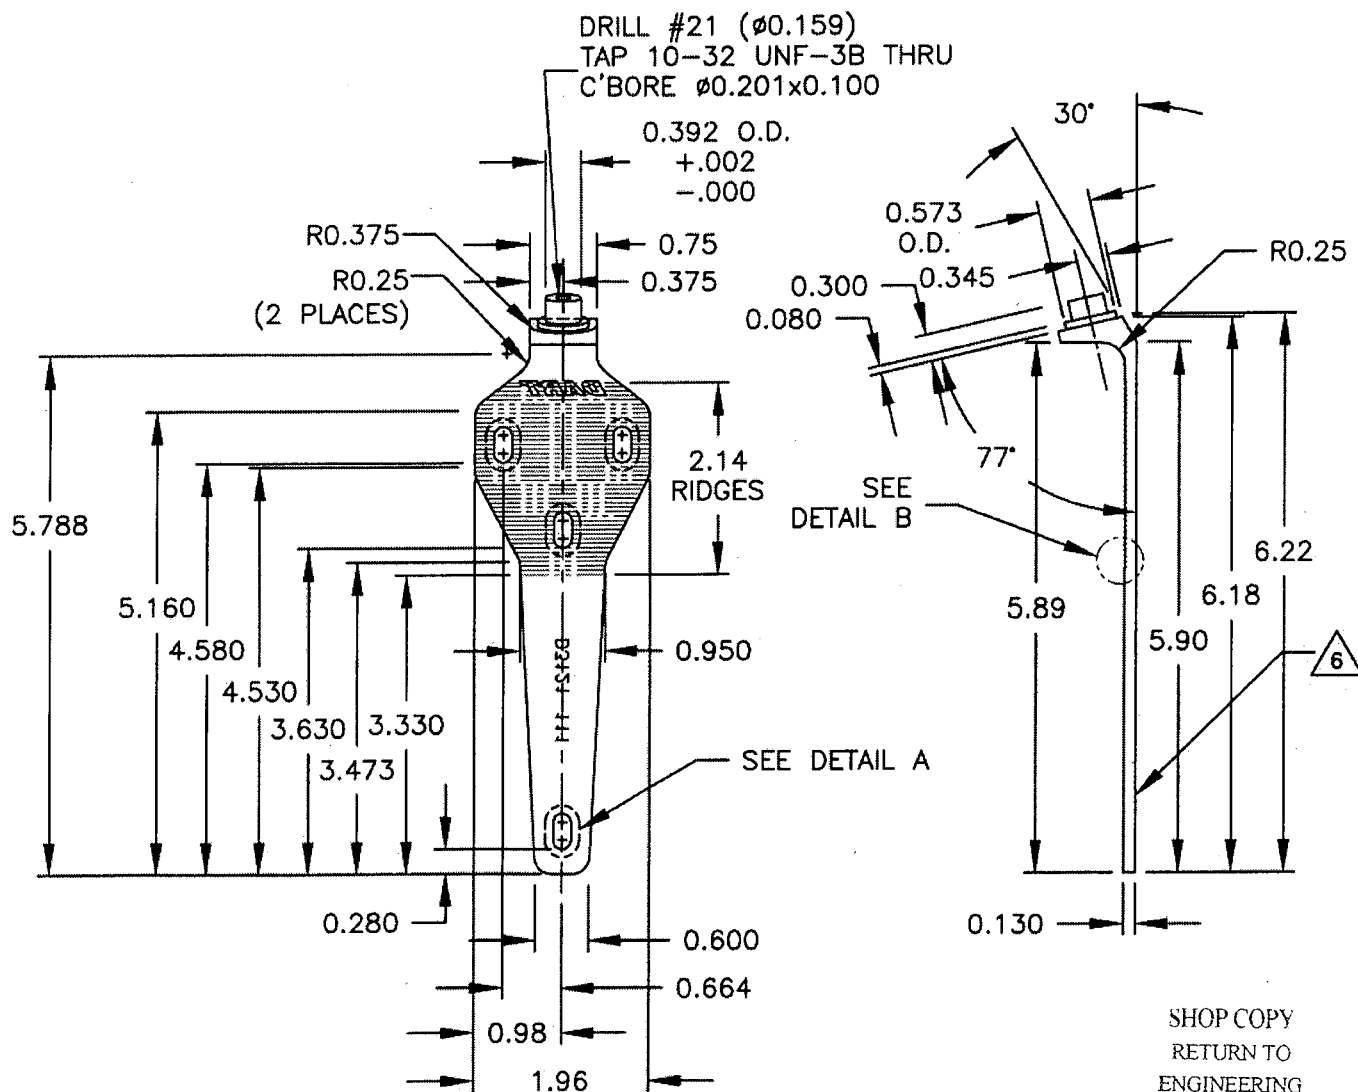

D3121-111 BRACKET

- 1) REPLACES PREMIER P/N B32-23001-11
- 2) MATERIAL: 17-4 SS PER AMS 5604/5643 (REF DART SPEC. M17-4-B)
MIN ULTIMATE TENSILE = 150 ksi
MIN YIELD TENSILE = 100 ksi
- 3) TOLERANCES ARE PER DART QSI 018 UNLESS OTHERWISE NOTED
- 4) ALL DIMENSIONS ARE IN INCHES
- 5) BREAK ALL SHARP EDGES 0.005 TO 0.015
- 6) ENGRAVE DART P/N & LOGO IN AREAS SHOWN
- 7) HOLE IN SPIGOT TO BE CONCENTRIC WITHIN 0.005

SHOP COPY
RETURN TO
ENGINEERING
UNCONTROLLED COPY
SUBJECT TO AMENDMENT
WITHOUT NOTICE
WORK ORDER
NO. 26043

RELEASED
04.03.01


Copyright © 2002 by DART AEROSPACE LTD

THIS DOCUMENT IS PRIVATE AND CONFIDENTIAL AND IS SUPPLIED ON THE EXPRESS CONDITION THAT IT IS NOT TO BE USED FOR ANY PURPOSE OR COPIED OR COMMUNICATED TO ANY OTHER PERSON WITHOUT WRITTEN PERMISSION FROM DART AEROSPACE LTD.



DESIGN <i>[Signature]</i>	DRAWN BY <i>[Signature]</i>	DART AEROSPACE LTD HAWKESBURY, ONTARIO, CANADA	
CHECKED <i>[Signature]</i>	APPROVED <i>[Signature]</i>	DRAWING NO. D3121	REV. C SHEET 8 OF 10
DATE 04.02.18	TITLE BRACKET ASSEMBLY		SCALE 1:2

RECEIVED
04.03.01 *[Signature]*

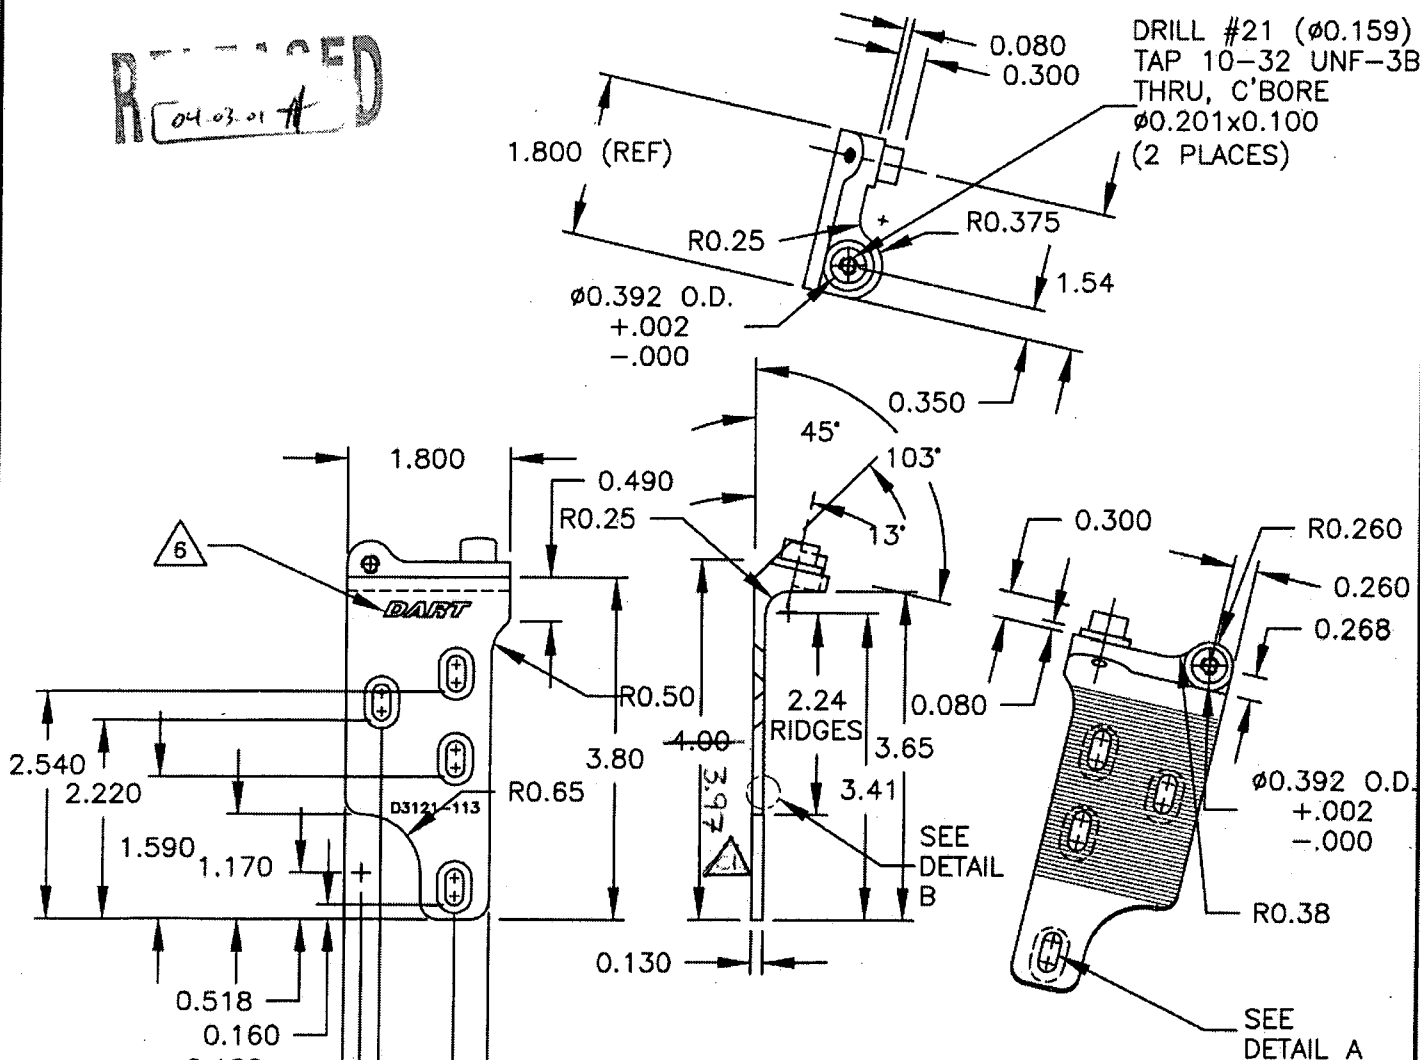

D3121-113 BRACKET (SHOWN)

D3121-114 BRACKET (OPPOSITE)

- 1) D3121-113 REPLACES PREMIER P/N B32-23001-13
D3121-114 REPLACES PREMIER P/N B32-23001-14
- 2) MATERIAL: 17-4 SS PER AMS 5604/5643
(REF DART SPEC. M17-4-B)
MIN ULTIMATE TENSILE STRENGTH = 150 ksi
MIN YIELD TENSILE STRENGTH = 100 ksi
- 3) TOLERANCES ARE PER DART QSI 018 UNLESS OTHERWISE NOTED
- 4) ALL DIMENSIONS ARE IN INCHES
- 5) BREAK ALL SHARP EDGES 0.005 TO 0.015
- 6) ENGRAVE DART P/N & LOGO IN AREAS SHOWN
- 7) HOLE IN SPIGOT TO BE CONCENTRIC WITHIN 0.005

SHOP COPY
RETURN TO
ENGINEERING
UNCONTROLLED COPY
SUBJECT TO AMENDMENT
WITHOUT NOTICE
WORK ORDER
NO. 26043


Copyright © 2002 by DART AEROSPACE LTD

THIS DOCUMENT IS PRIVATE AND CONFIDENTIAL AND IS SUPPLIED ON THE EXPRESS CONDITION THAT IT IS NOT TO BE USED FOR ANY PURPOSE OR COPIED OR COMMUNICATED TO ANY OTHER PERSON WITHOUT WRITTEN PERMISSION FROM DART AEROSPACE LTD.



DESIGN #	DRAWN BY GP	DART AEROSPACE LTD HAWKESBURY, ONTARIO, CANADA	
CHECKED #	APPROVED #	DRAWING NO. D3121	REV. C SHEET 9 OF 10
DATE 04.02.18		TITLE BRACKET ASSEMBLY	SCALE 1:2

RELEASED
04.03.01 #

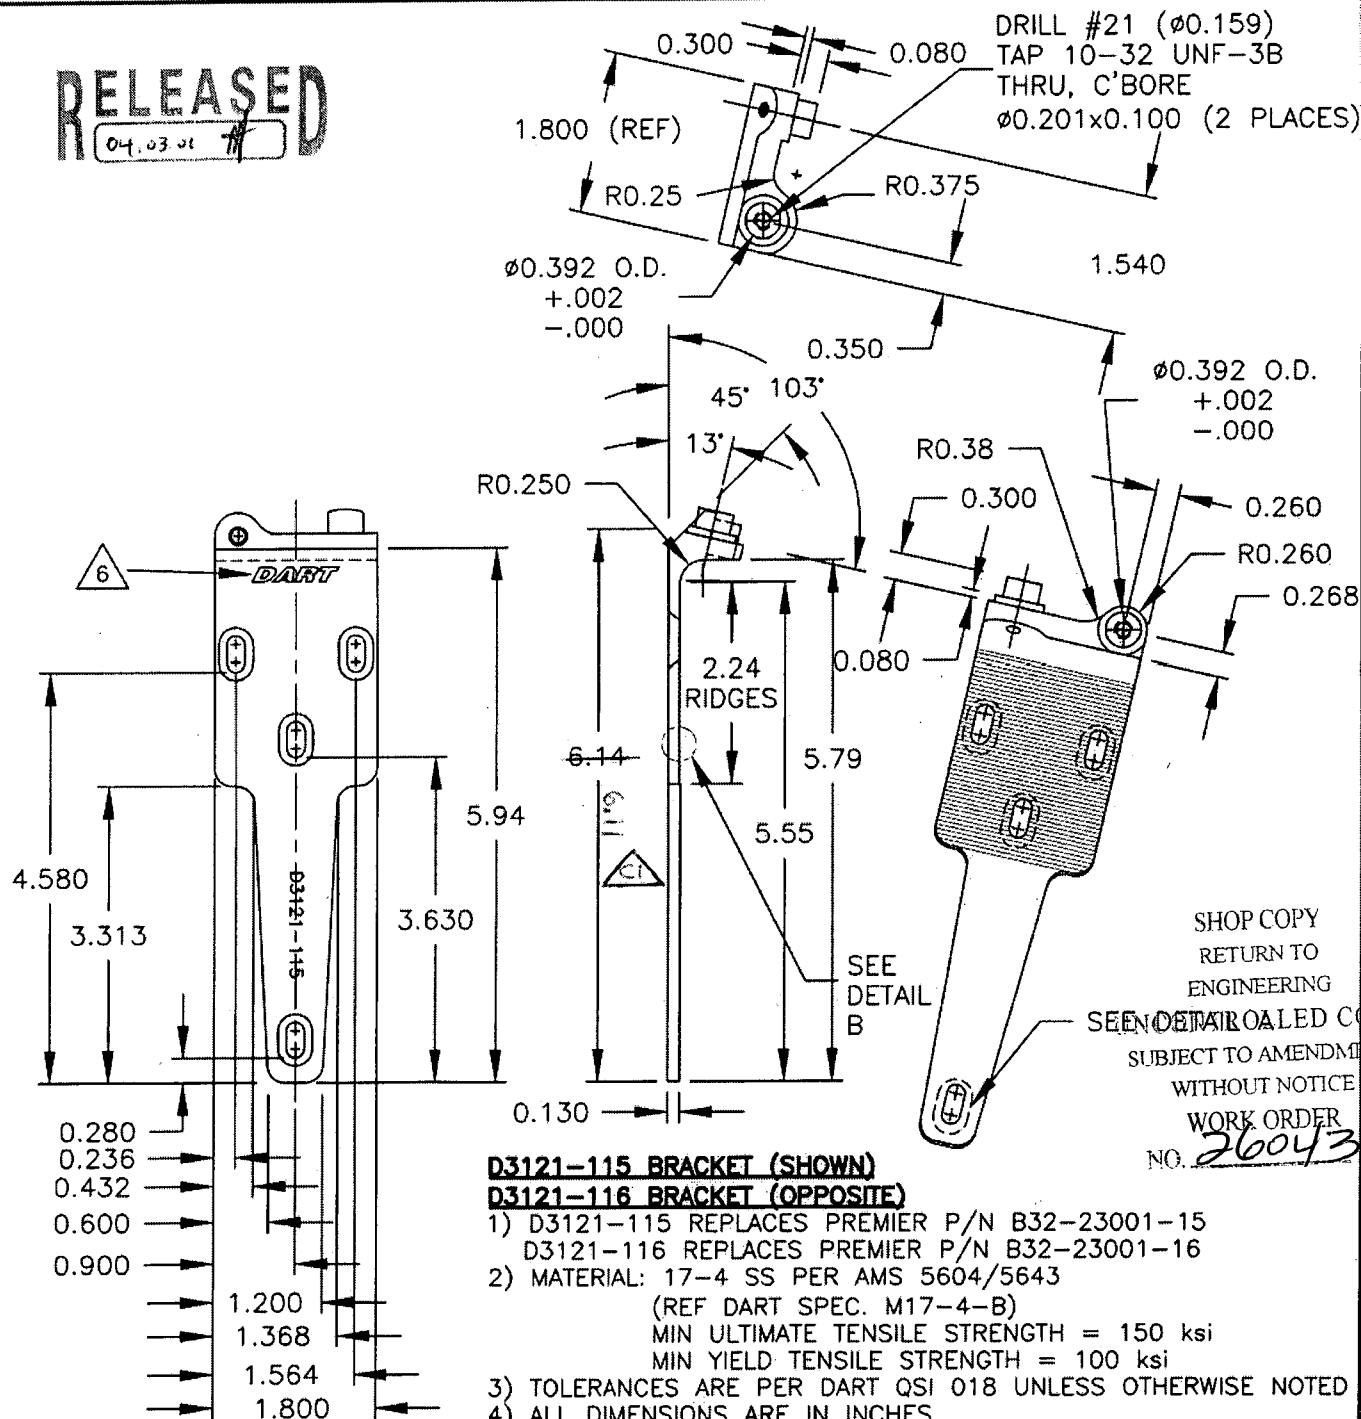

SHOP COPY
RETURN TO
ENGINEERING
SUBJECT TO AMENDMENT
WITHOUT NOTICE
WORK ORDER
NO. 26043

D3121-115 BRACKET (SHOWN)

D3121-116 BRACKET (OPPOSITE)


- 1) D3121-115 REPLACES PREMIER P/N B32-23001-15
D3121-116 REPLACES PREMIER P/N B32-23001-16
- 2) MATERIAL: 17-4 SS PER AMS 5604/5643
(REF DART SPEC. M17-4-B)
MIN ULTIMATE TENSILE STRENGTH = 150 ksi
MIN YIELD TENSILE STRENGTH = 100 ksi
- 3) TOLERANCES ARE PER DART QSI 018 UNLESS OTHERWISE NOTED
- 4) ALL DIMENSIONS ARE IN INCHES
- 5) BREAK ALL SHARP EDGES 0.005 TO 0.015
- 6) ENGRAVE DART P/N & LOGO IN AREAS SHOWN
- 7) HOLE IN SPIGOT TO BE CONCENTRIC WITHIN 0.005

Copyright © 2002 by DART AEROSPACE LTD


THIS DOCUMENT IS PRIVATE AND CONFIDENTIAL AND IS SUPPLIED ON THE EXPRESS CONDITION THAT IT IS NOT TO BE USED FOR ANY PURPOSE OR COPIED OR COMMUNICATED TO ANY OTHER PERSON WITHOUT WRITTEN PERMISSION FROM DART AEROSPACE LTD.

DART


DESIGN	DRAWN BY	DART AEROSPACE LTD HAWKESBURY, ONTARIO, CANADA	
CHECKED	APPROVED	DRAWING NO. D3121	REV. C SHEET 10 OF 10
DATE 04.02.17		TITLE BRACKET ASSEMBLY	SCALE 1:1

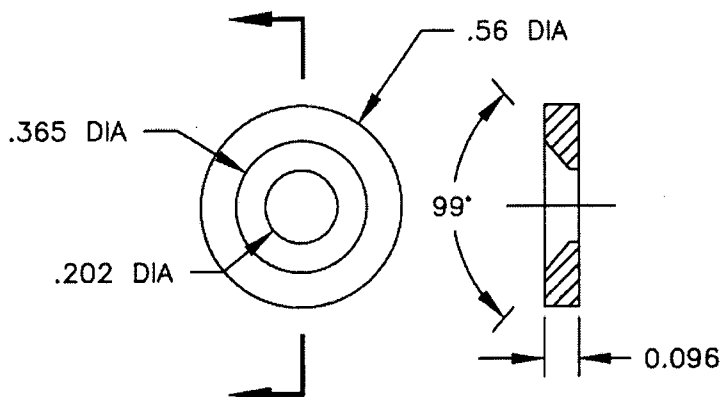**D3121-17 WASHER (SCALE 2:1)**


- 1) REPLACES PREMIER P/N B32-23001-17
- 2) MATERIAL: AISI 303 SS ROUND BAR, ANNEALED (REF DART SPEC. M303R)
- 3) TOLERANCES ARE PER DART QSI 018 UNLESS OTHERWISE NOTED
- 4) ALL DIMENSIONS ARE IN INCHES
- 5) BREAK ALL SHARP EDGES 0.005 TO 0.015

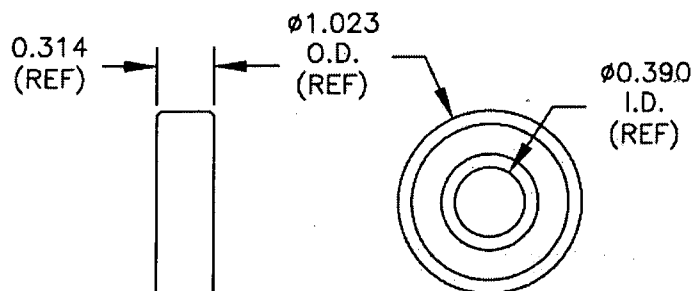**D3121-19 BEARING (SCALE 1:1)**


- 1) POSSIBLE SUPPLIER: KING BEARING P/N 6000-2ZJ/EM FAFNIR P/N 9100KDD
- 2) ALL DIMENSIONS ARE IN INCHES

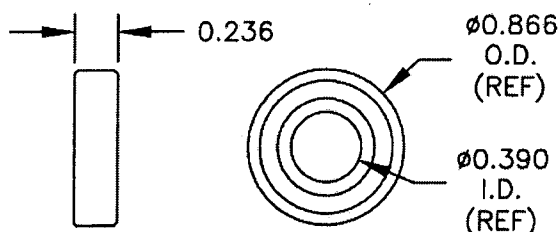**D3121-23 BEARING (SCALE 1:1)**

- 1) POSSIBLE SUPPLIER: SKF P/N 61900-2Z OR KML P/N 6900-ZZ
- 2) ALL DIMENSIONS ARE IN INCHES

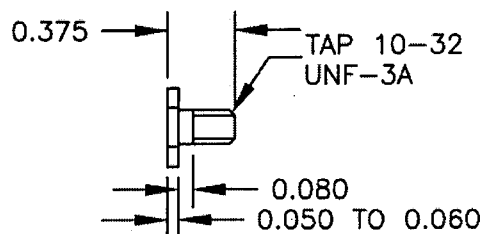
**D3121-21 BOLT (SCALE 1:1)**

- 1) MATERIAL: AISI 303 SS HEX, ANNEALED (REF DART SPEC. M303H0.500)
- 2) FINISH: NONE
- 3) TOLERANCES ARE PER DART QSI 018 UNLESS OTHERWISE NOTED
- 4) ALL DIMENSIONS ARE IN INCHES
- 5) BREAK ALL SHARP EDGES 0.005 TO 0.015

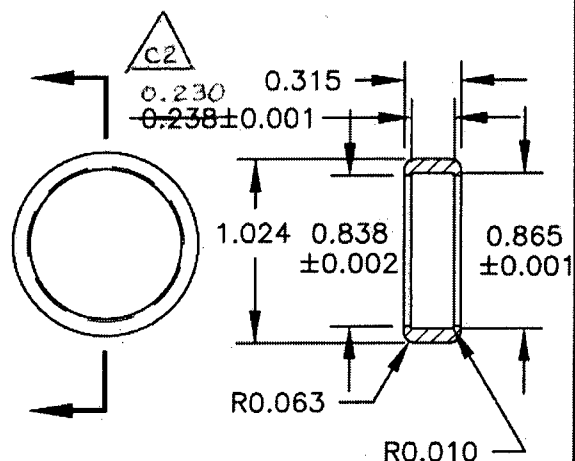**D3121-25 CAP (SCALE 1:1)**

- 1) MATERIAL: DELRIN ROD, Ø1.25 (REF DART SPEC. M-DELIN-R1.250)
- 2) TOLERANCES ARE PER DART QSI 018 UNLESS OTHERWISE NOTED
- 3) ALL DIMENSIONS ARE IN INCHES

SHOP COPY
RETURN TO
ENGINEERING
RELEASED
NO CONTROL COPY
NO AMENDMENT
WITHOUT NOTICE
WORK ORDER
NO. 26043

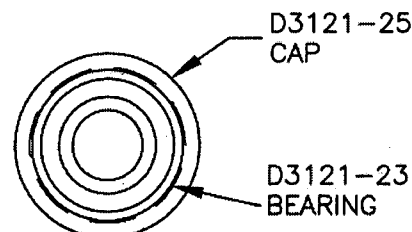**D3121-241 BEARING ASSEMBLY (SCALE 1:1)**

Copyright © 2002 by DART AEROSPACE LTD

THIS DOCUMENT IS PRIVATE AND CONFIDENTIAL AND IS SUPPLIED ON THE EXPRESS CONDITION THAT IT IS NOT TO BE USED FOR ANY PURPOSE OR COPIED OR COMMUNICATED TO ANY OTHER PERSON WITHOUT WRITTEN PERMISSION FROM DART AEROSPACE LTD.

Chris Provencal

From: David Shepherd [davids@dartaero.com]
Sent: March 14, 2006 8:55 PM
To: Chris Provencal
Subject: Re: NCR D3121-113/-114

Acceptable deviation.

David

----- Original Message -----

From: "Chris Provencal" <cprovencal@dartaero.com>
To: <davids@dartaero.com>
Sent: Tuesday, March 14, 2006 2:34 PM
Subject: NCR D3121-113/-114

>
> For one D3121-113/-114 bracket, the 0.160, 1.590, 2.220, & 2.540
dimensions
> on dwg D3121 Rev. C are under tolerance be 0.008" (ie, the 0.160"
dimension
> is 0.142"). What this means is that all four slots are shifted in
relation
> to the rest of the part. The other dimensions are OK. Is this
acceptable?
> I don't think its a big deal because the holes are adjustable anyway and
the
> 0.008" shouldn't make too much of a difference.
>
> Sincerely,
> Chris Provencal
> DART Aerospace Ltd.
> Email..cprovencal@dartaero.com
> Phone....613-632-3336
> Fax.....613-632-4443
>
>